


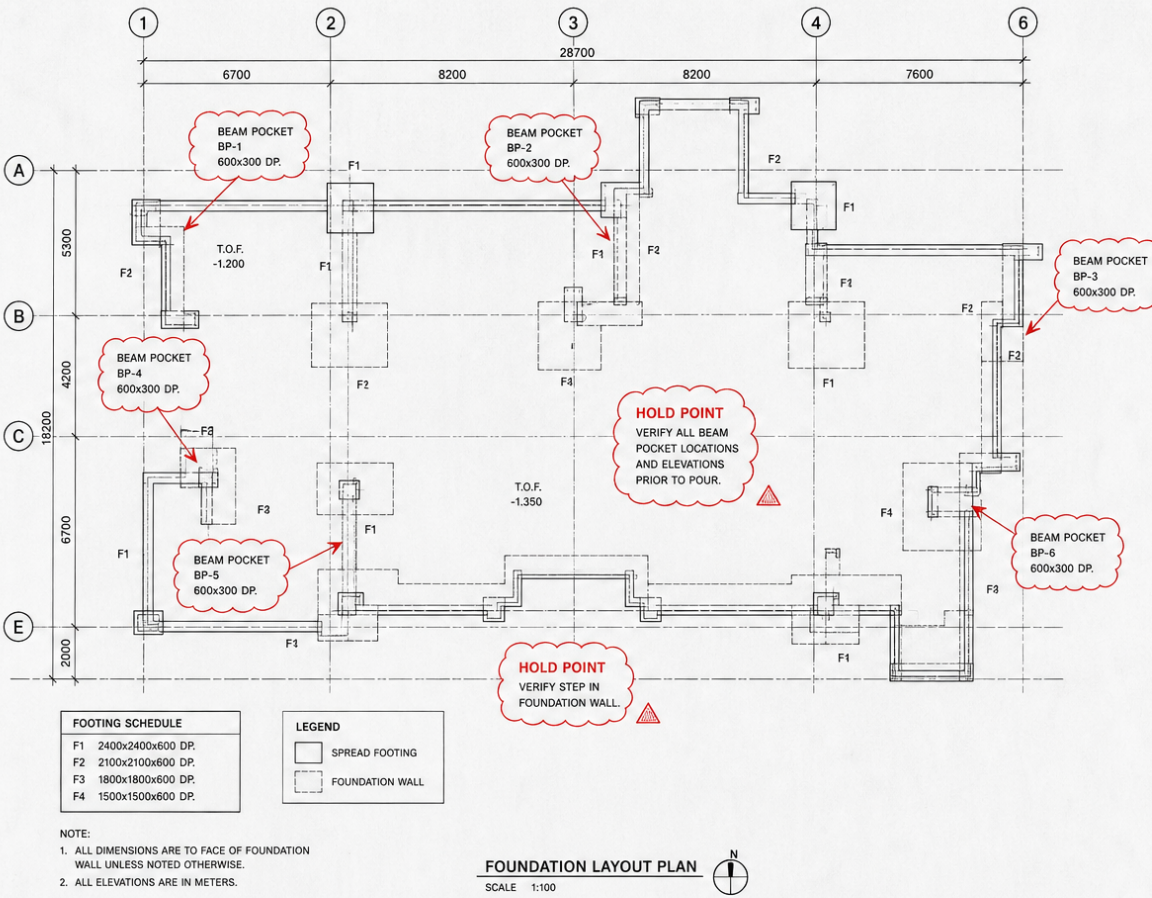

GENERAL NOTES

- CONTRACTOR TO VERIFY ALL DIMENSIONS AND ELEVATIONS ON SITE.
- REPORT ANY DISCREPANCIES TO THE ENGINEER BEFORE PROCEEDING.
- DO NOT SCALE DRAWINGS.
- ALL WORK TO COMPLY WITH PROJECT SPECIFICATIONS AND APPLICABLE CODES.

REVISIONS

REV.	DATE	DESCRIPTION	BY
A	2026-07-22	ISSUED FOR REVIEW	AA
B	2026-07-29	FOUNDATION LAYOUT MARKUP	AA

KEY PLAN

PROJECT

HARBOR BUILD PROJECT ALPHA

DRAWING TITLE

FOUNDATION LAYOUT MARKUP

DRAWN BY	CHECKED BY	APPROVED BY
AA	BB	CC

PROJECT NO.	DATE
ALP-2026	2026-07-29

DRAWING NO.	REV.
CO-014	B

PROJECT BUDGET (JPY)

JPY 18,600,000