

HARBOR BUILD
PROJECT ALPHA 2026

BIM COORDINATION OVERLAY

LEVEL 02

DISCIPLINE OVERLAYS


- Architectural Shell**
Walls / Floors / Ceilings / Openings
- Structure**
Beams / Columns / Slabs / Bracing
- Mechanical (HVAC)**
Ductwork / AHU Zones / Equipment
- Electrical**
Cable Trays / Conduits / Panels

SYMBOLS


- Column (Structure)
- Beam (Structure)
- Duct (Mechanical)
- Pipe (Mechanical)
- Cable Tray (Electrical)
- Conduit (Electrical)
- Equipment
- Coordination issue




DETAIL - CLASH-07

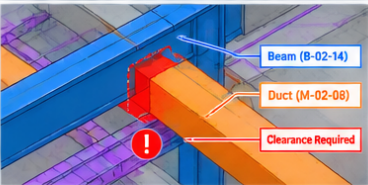

LEVEL 02 - ZONE MAP

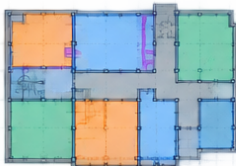

KEY PLAN

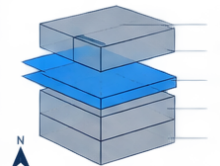

PLAN VIEW (LEVEL 02)




COORDINATION ISSUES


ID	DISCIPLINES	DESCRIPTION	STATUS
CLASH-07	Mech / Struct	Duct vs Beam	Open
CLASH-12	Elec / Mech	Tray vs Duct	Open
CLASH-18	Elec / Struct	Conduit vs Slab	In Review
CLASH-21	Mech / Arch	AHU Clearance	Resolved

SECTION VIEWS

Section A-A

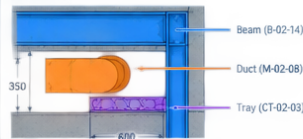

Section B-B

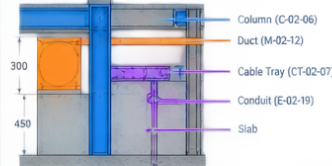

PROJECT ALPHA LEVEL 02 COORDINATION OVERLAY
2026-07-29

INTEGRATED DESIGN | CLASH DETECTION | CONSTRUCTABILITY

REVISION
CO-014

DRAWING NO.
PA-02-COORD-014

SCALE
As indicated