

HARBOR BUILD

PROJECT BETA

DESIGN PHASE

FOUNDATION LAYOUT

GENERAL NOTES:

1. REFER TO SHEET S0.01 FOR GENERAL NOTES.
2. ALL FOOTINGS CENTERED ON COLUMNS AND PIERS UNO.
3. TOP OF FOOTINGS @ EL. 100'-0" UNO.
4. SEE SHEET S1.01 FOR FOUNDATION DETAILS.


LEGEND:


-  SPREAD FOOTING
-  PIER
-  GRADE BEAM / FOUNDATION WALL
-  ELEVATOR PIT
-  SERVICE TRENCH (REFERENCE)

S1.02

PRELIMINARY

2026-07-29

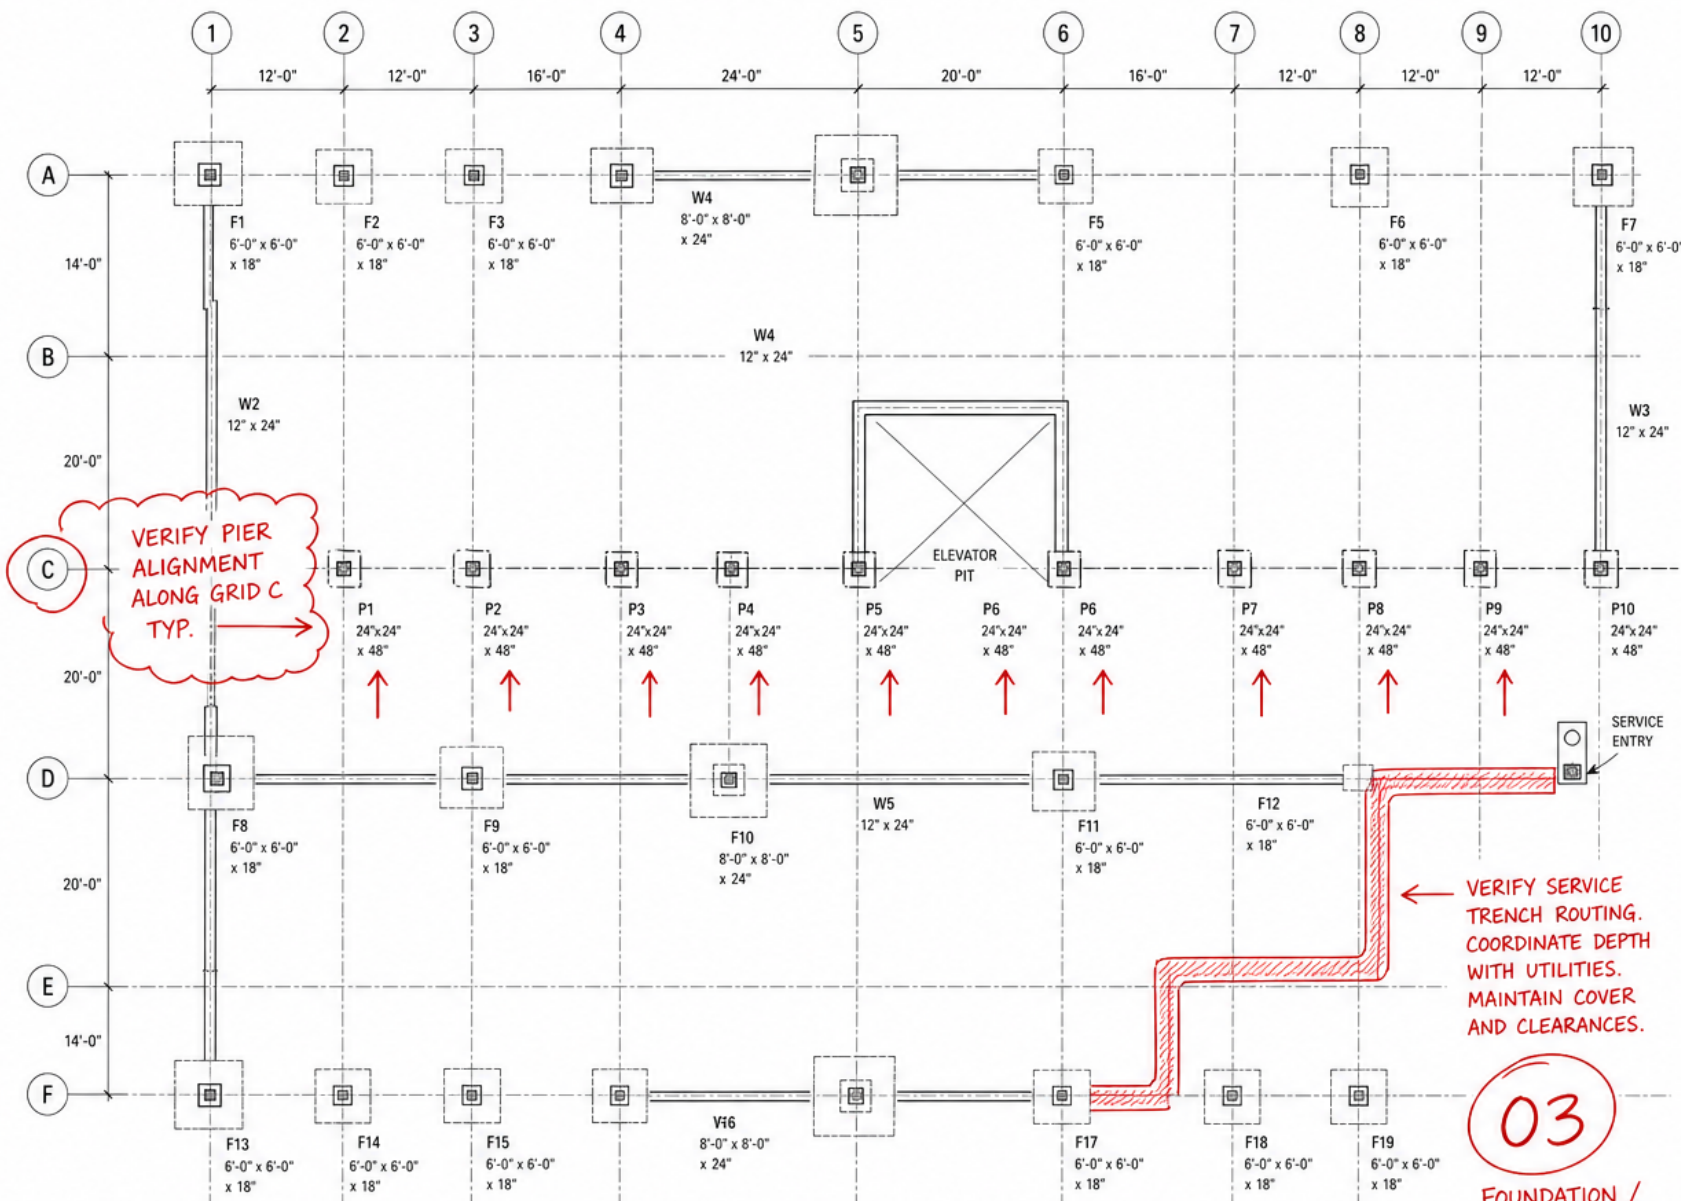

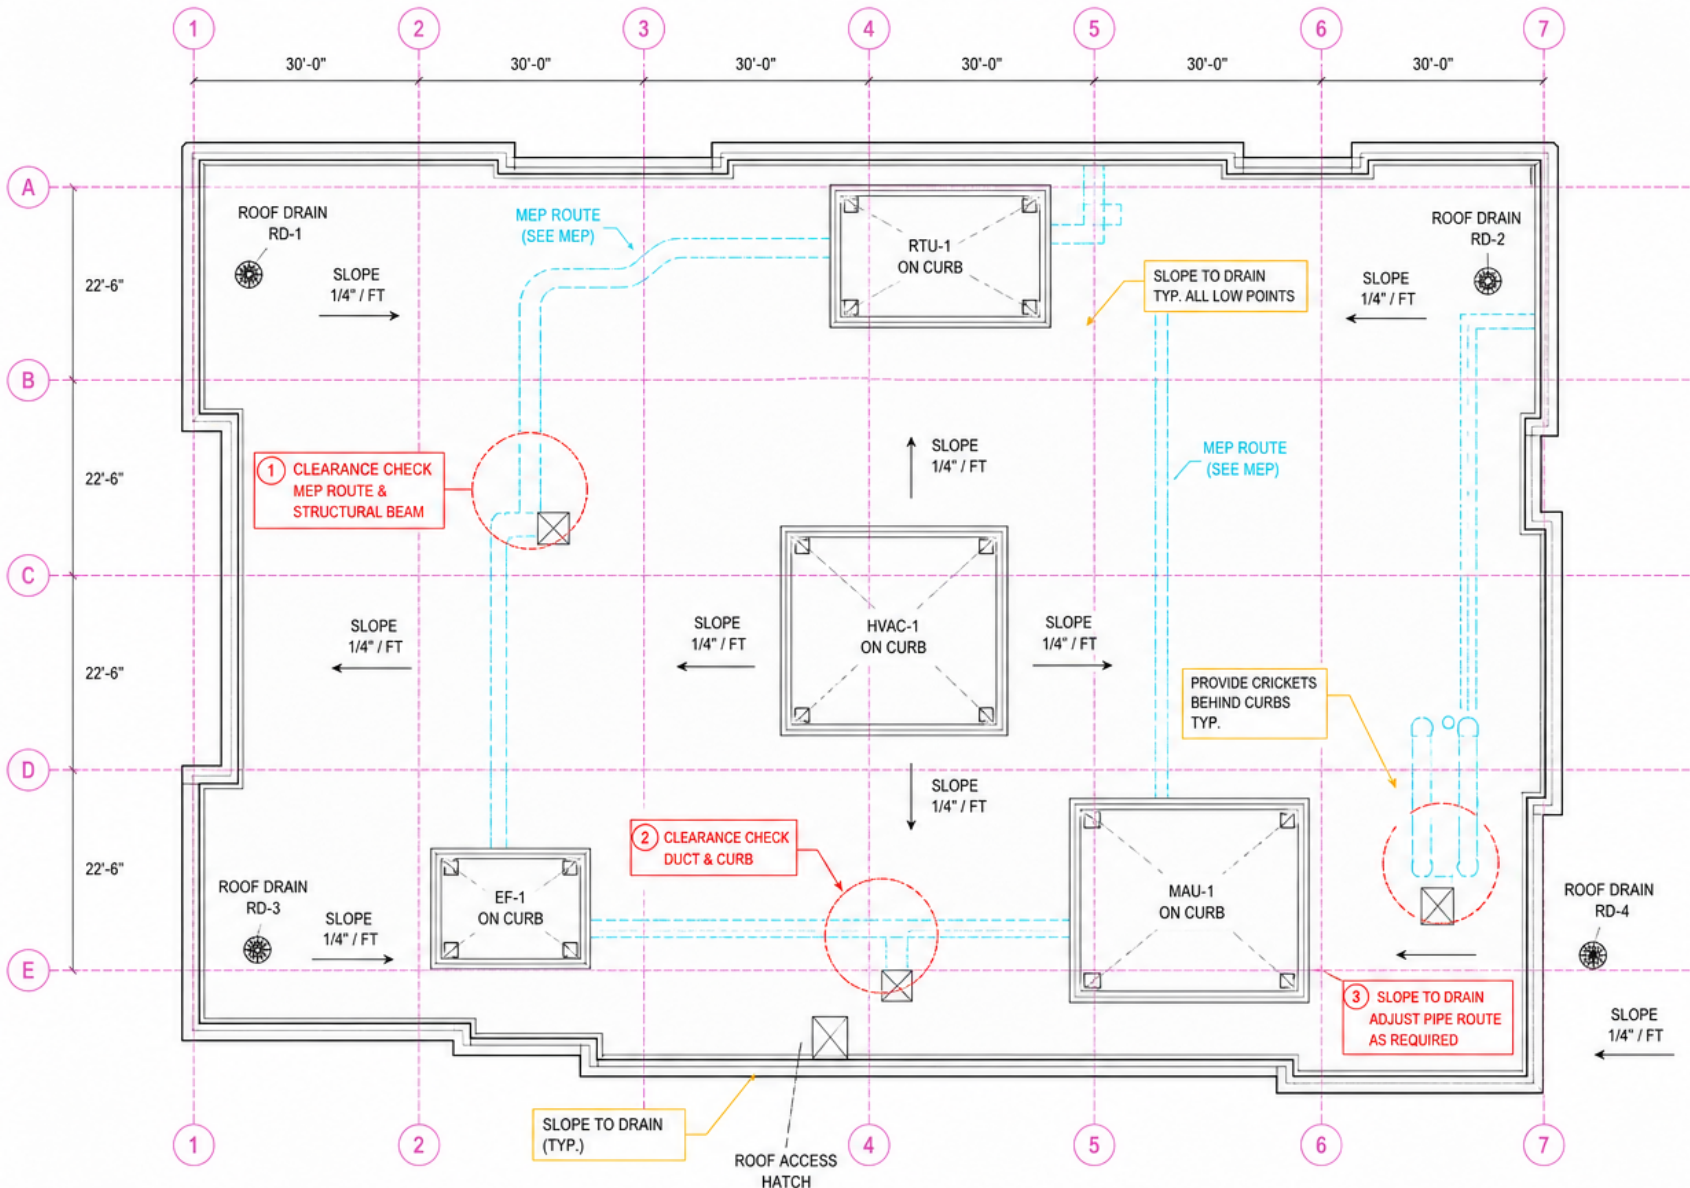

ROOF PLAN




GENERAL NOTES

1. REFER TO ARCHITECTURAL SHEETS FOR ROOFING ASSEMBLY AND DETAILS.
2. REFER TO STRUCTURAL SHEETS FOR ROOF FRAMING AND EQUIPMENT SUPPORT.
3. REFER TO MEP SHEETS FOR EQUIPMENT AND ROUTING INFORMATION.
4. COORDINATE ALL PENETRATIONS AND OPENINGS.

LEGEND

- ARCHITECTURAL (ROOF)
- - - MEP ROUTE (COORDINATION)
- - - STRUCTURAL GRID
- DRAINAGE / SLOPE CALLOUT
- COORDINATION CLASH

KEY PLAN

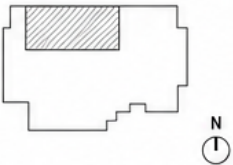

REVISION SCHEDULE

NO.	DATE	DESCRIPTION

PROJECT BETA
ROOF COORDINATION


A1.41

PRELIMINARY

2026-07-29

SCALE: 1/8" = 1'-0"



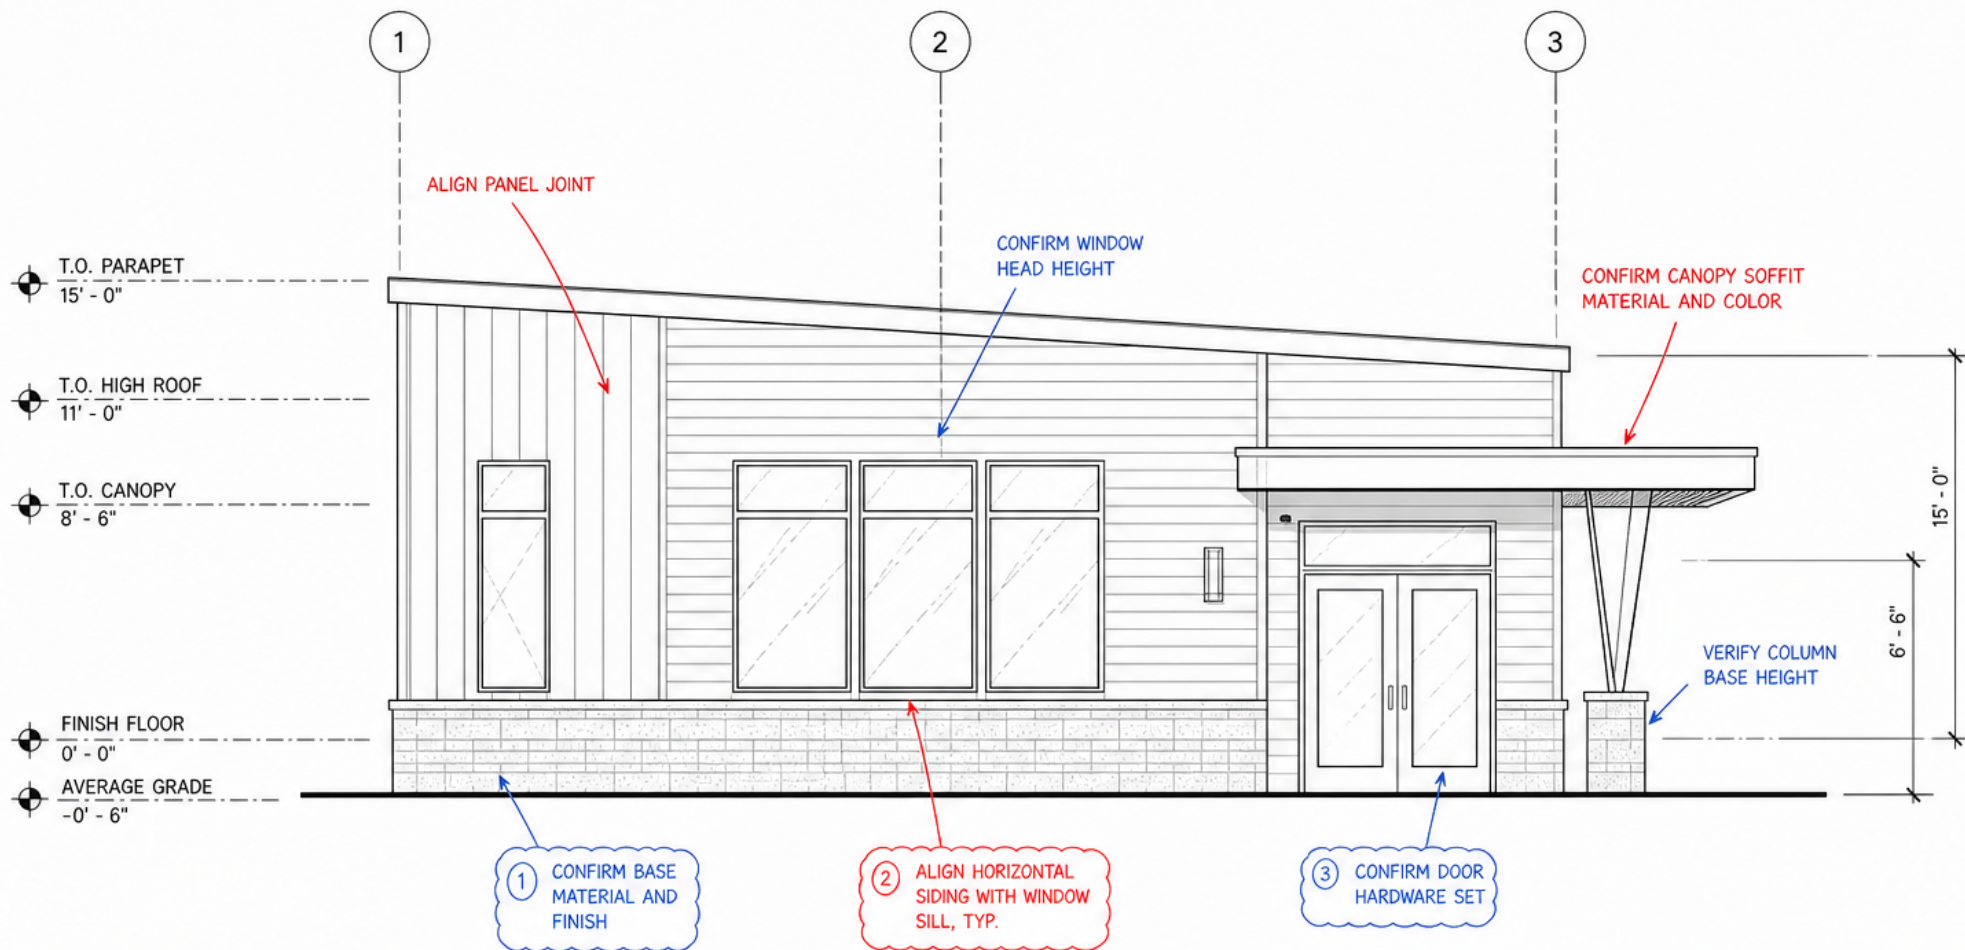

FIELD NOTES:

- ① CONFIRM BASE MATERIAL, COLOR, AND JOINT PROFILE.
- ② ALIGN HORIZONTAL SIDING WITH WINDOW SILL, TYPICAL.
- ③ CONFIRM DOOR HARDWARE SET AND FINISH.

PROJECT BETA

WEST ELEVATION

SCALE: 1/4" = 1'-0"

DESIGN PHASE

PRELIMINARY – NOT FOR CONSTRUCTION

2026-07-29

A3.20

PRELIMINARY